

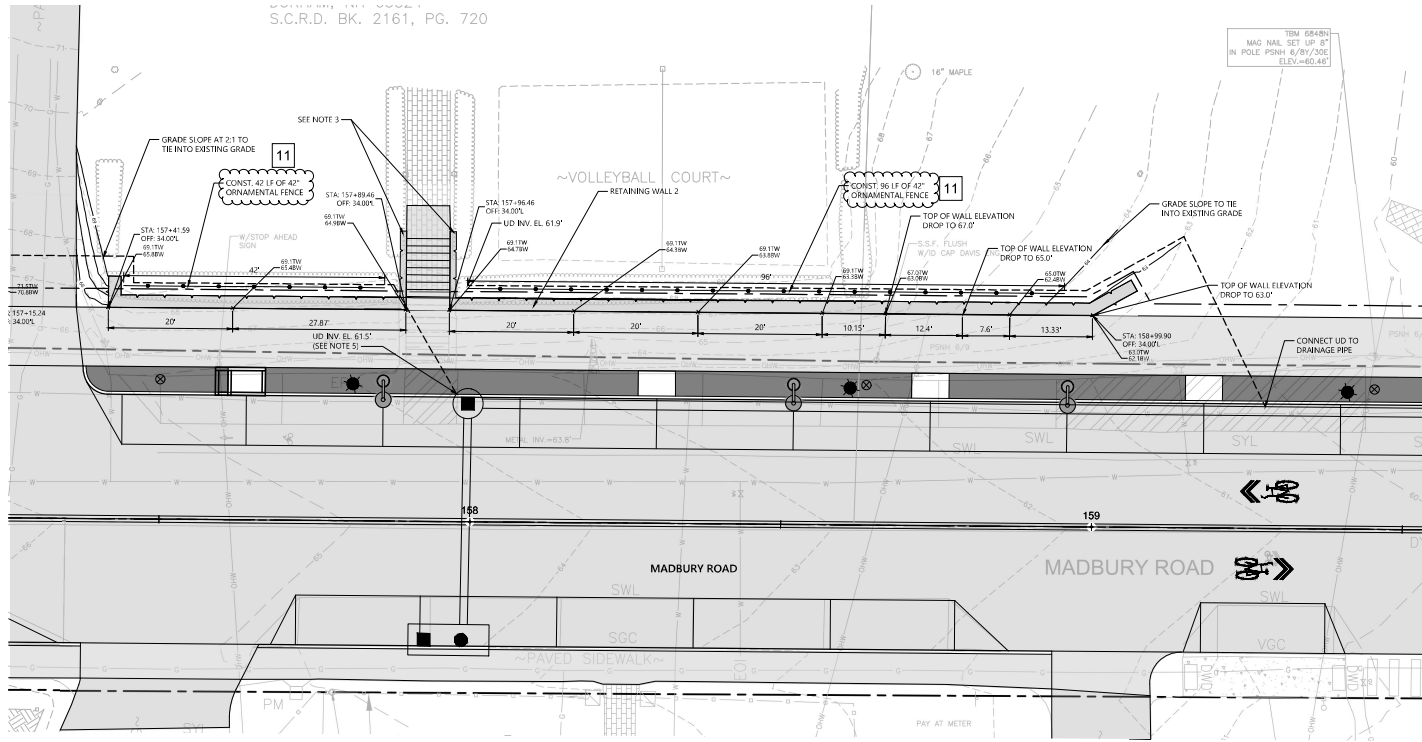


S.C.R.D. BK. 2161, PG. 720

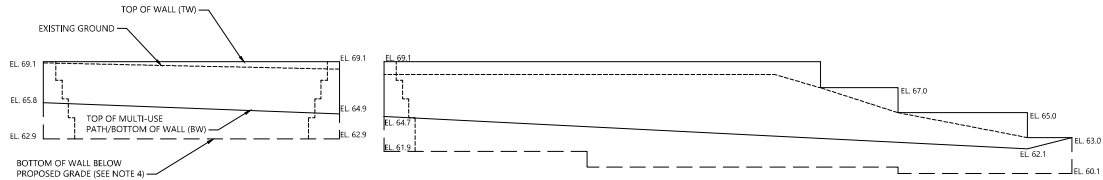

RETAINING WALL 2 PLAN VIEW

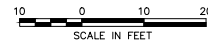

RETAINING WALL 2 ELEVATION VIEW
(VERTICAL SCALE = 2:1)

DESCRIPTION	REVISIONS AFTER PROPOSAL
	STATION
	DATE
	NUMBER
DATE	DATE
	DATE
	DATE
	DATE
AS BUILT DETAILS	DATE
	DATE
	DATE
	DATE

- Notes:**
1. TW INDICATES THE TOP OF WALL ELEVATION AT IDENTIFIED LOCATIONS
 2. BW INDICATES THE BOTTOM OF WALL AT THE TOP OF THE MULTI-USE PATH AT THE FACE OF WALL AT IDENTIFIED LOCATIONS
 3. SEE GRANITE STEP DETAILS IN LANDSCAPE PLANS FOR WALL DETAILS ALONG STAIRS
 4. STEPS ALONG BOTTOM OF WALL BELOW PROPOSED GRADE SHOWN SCHEMATICALLY. CONTRACTOR SHALL DETERMINE STEPS BASED ON APPROVED MATERIAL AND SITE CONDITIONS.
 5. CONTRACTOR SHALL CONFIRM INVERTS PRIOR TO FABRICATING CATCH BASIN. UNDERDRAIN SHALL BE SLOPED A MINIMUM OF 0.2% TO THE CATCH BASIN WITH A MINIMUM OF 3.5 FEET OF COVER BELOW ANY PAVED SURFACES.

REVISIONS AFTER ADVERTISEMENT (5-20-24)	
11	FENCE - 48-INCH WILL BE PROVIDED BY THE TOWN, AND MOUNTING SLEEVES SHALL BE INSTALLED BY THE CONTRACTOR



DATE PLOTTED	VHB PROJECT NO.	DRAWING	STATE PROJECT NO.	SHEET NO.	TOTAL SHEETS
2/19/2024	52830.00	52830_GRD_Phase1.dwg	-	49	71

MADBURY ROAD COMPLETE STREETS PROJECT - SEGMENT 1
TOWN OF DURHAM NEW HAMPSHIRE

RETAINING WALL 2 PLANS