

**LOCATION PLAN**


**LEGEND**

- 5/8" IRON ROD w/ID CAP TO BE SET
- IRON ROD PER NOTE 1
- ⊙ DRILL HOLE PER NOTE 1
- n/f NOW OR FORMERLY
- S.C.R.D. STRAFFORD COUNTY REGISTRY OF DEEDS
- ∞∞∞∞ STONE WALL
- - - - - POORLY DRAINED SOIL
- - - - - BUILDING SETBACK

**NOTES**

1. REFERENCE PLANS:  
 "SUBDIVISION PLAN-FITTS FARM-EMERSON ROAD & EDGEWOOD ROAD, DURHAM, NEW HAMPSHIRE" BY TRITECH CORPORATION DATED JULY 30, 1999. S.C.R.D. PLAN No. 61-52 & 61-53.
2. FOR OPEN SPACE, EXTERIOR BOUNDARY AND EASEMENT INFORMATION SEE ABOVE PLAN REFERENCES.

| ISSUE | DATE | DESCRIPTION | BY | CHKD. | APP. |
|-------|------|-------------|----|-------|------|
|       |      |             |    |       |      |
|       |      |             |    |       |      |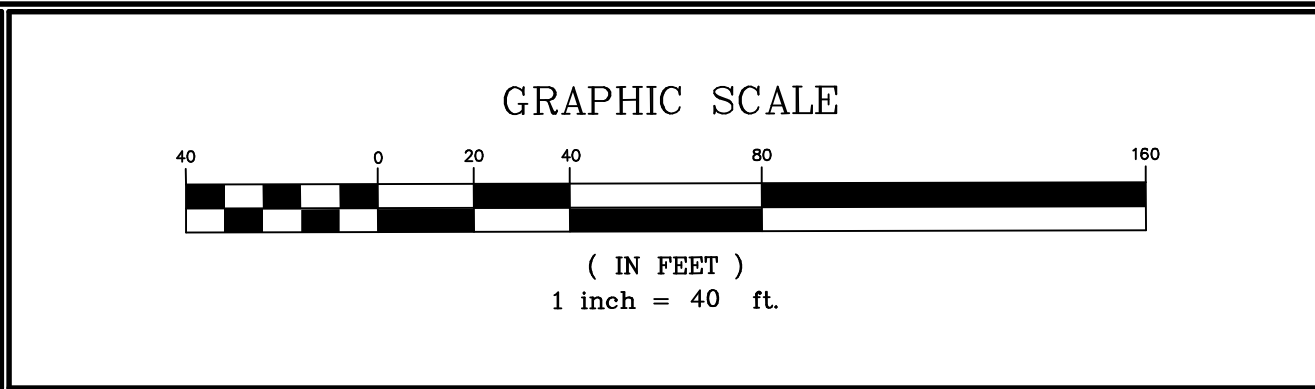
**ATLANTIC**  
SURVEY CO., LLC

149 Mill Road, Durham, New Hampshire 03824

PREPARED BY: SURVEYORS  
 PLANNERS  
 SEPTIC DESIGNERS

603-659-8939

DATE: Nov, 2015

FIELDWORK BY: AF

DESIGNED BY: AF

CAD FILE: 09141-Conditional Use

PROJECT No.: 09141

SHEET 1 OF 1

**AS-BUILT LANDSCAPE PLAN**

**Perley Lane Land Unit Condominium**

LOCATED AT  
**Perley Lane, Durham, Strafford County, N.H.**